

**RESOLUTION NO. 2008 – 057**

**A RESOLUTION OF THE TOWN COUNCIL OF THE TOWN OF SOUTHWEST RANCHES, FLORIDA AUTHORIZING THE EXPENDITURE OF AN AMOUNT NOT TO EXCEED \$85,000.00 TO WEEKLEY ASPHALT AND PAVING, INC. ("WEEKLEY"), UNDER THE TERMS OF ITS EXISTING PIGGY-BACK AGREEMENT, FOR THE PROVISION OF CERTAIN DRAINAGE IMPROVEMENTS AT THE NW CORNER OF 172<sup>nd</sup> AVENUE AND 46<sup>TH</sup> STREET, THE PUBLIC SAFETY COMPLEX SITE; AND PROVIDING AN EFFECTIVE DATE.**

**WHEREAS**, on February 7, 2008, pursuant to Resolution No. 2008-043, the Town Council approved piggy-backing off an existing Agreement between Weekley Asphalt and Paving Inc. ("Weekly") and Broward County (the "County") to provide General Roadway Repair and Miscellaneous Construction Services; and

**WHEREAS**, the Town is currently planning to construct a Public Safety Complex on the northwest corner of 172<sup>nd</sup> Avenue and 46<sup>th</sup> Street; and

**WHEREAS**, this site is in need of drainage improvements before such construction can begin; and

**WHEREAS**, the Town Council wishes to authorize WEEKLEY to perform the necessary drainage improvements, as delineated in "Exhibit A", relating to the Public Safety Complex site.

**NOW, THEREFORE, BE IT RESOLVED** by the Town Council of the Town of Southwest Ranches, Florida:

**Section 1.** The above referenced recitals are true and correct and are incorporated herein by reference.

**Section 2.** The Town Council hereby authorizes an expenditure to Weekley, under the terms of its existing piggy-back agreement, to perform certain drainage improvements, as specifically delineated in Exhibit "A", relating to the Public Safety Complex site, in an amount not to exceed \$85,000.00.

**Section 3.** The Town Council hereby authorizes the Mayor, Town Administrator and Town Attorney to execute any all documents necessary to effectuate the intent of the Resolution.

**Section 4.** That this Resolution shall become effective immediately upon its adoption.

**PASSED AND ADOPTED** by the Town Council of the Town of Southwest Ranches, Florida, this 3<sup>rd</sup> day of April 2008, on a motion by Council Member Don Maines and seconded by Council Member Steve Breitkreuz.

Fink	<u>Y</u>	Ayes	<u>5</u>
Nelson	<u>Y</u>	Nays	<u>0</u>
Breitkreuz	<u>Y</u>	Absent	<u>0</u>
Knight	<u>Y</u>	Abstaining	<u>0</u>
Maines	<u>Y</u>		




Mecca Fink  
Mecca Fink, Mayor

ATTEST:



Susan A. Owens, CMC, Town Clerk

Approved as to Form and Correctness:

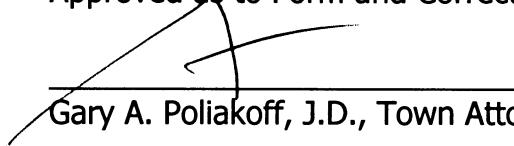


Gary A. Poliakoff, J.D., Town Attorney

FTL\_DB: 1106968\_1

## **VOLUNTEER FIRE DEPARTMENT / S.W. 46th STREET**

**TOWN OF SOUTHWEST RANCHES, BROWARD COUNTY, FLORIDA**

# TOWN OF SOUTHWEST RANCHES

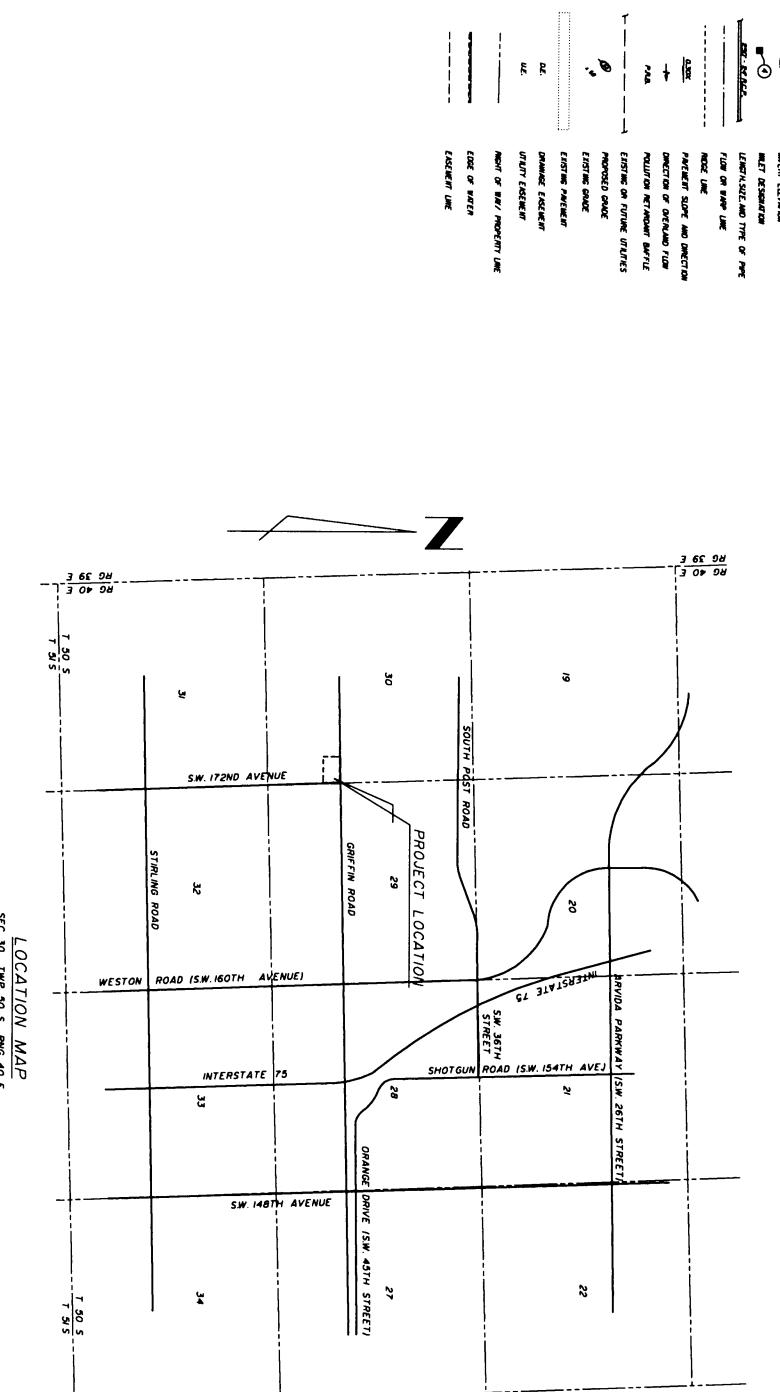

## **DRAINAGE IMPROVEMENTS**


LITERATURE

**48 HOURS BEFORE DIGGING**  
**BROWNS - PAUL BEACH - MARTIN RIVER**  
**ST. LUCIE - MARTIN COUNTIES**  
**CAL. - NEW MEX.**  
**1-800-432-4770**  
**SUNSHINE STATE CALL**  
**UNDERGROUND UTILITIES**  
**NOTIFICATION CENTER**

NOTES FOR SGT FENSTER



MITES FOR BANDED HAY OR STRAW BARRIERS

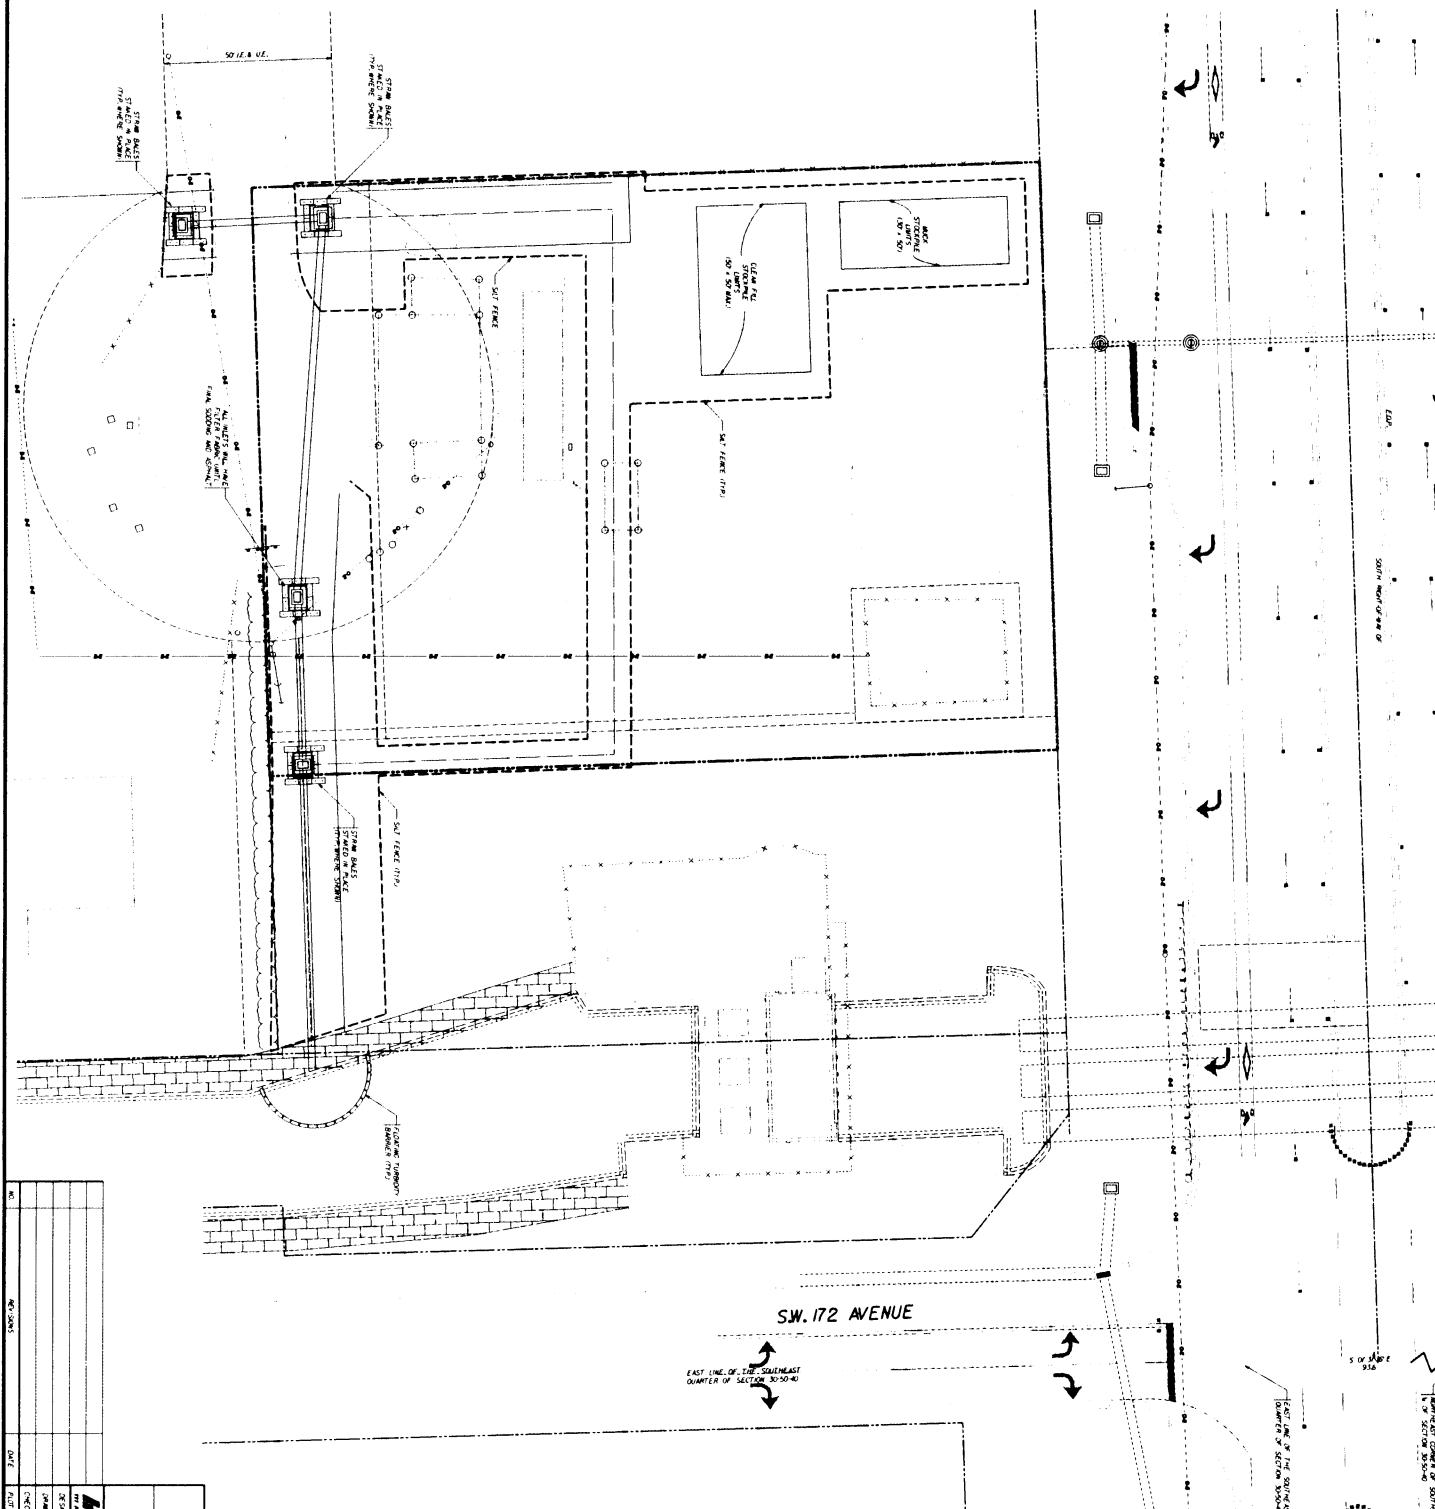


ANSWER

VOLUNTEER







**BARRIER FOR PAVED DITCH**

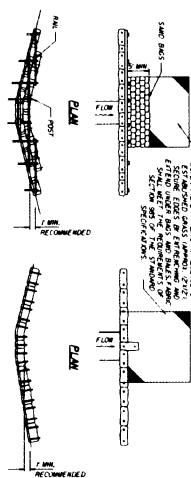


**BARRIERS FOR UNPAVED DITCHES**

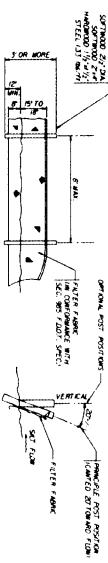


**TYPE IV SILT FENCE**

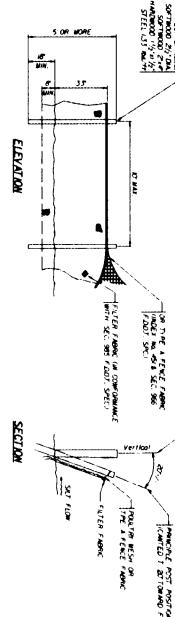


**SECTION**

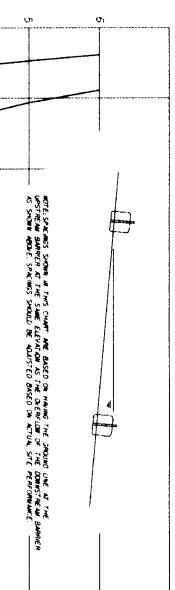

NOTE: SPACING SHOULD BE IN FEET. CENTER LINE BASED ON NUMBER OF BARRIERS AND THE LENGTH OF THE CONTRACTOR.

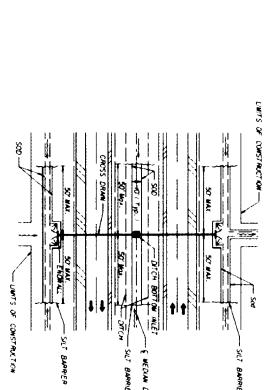

**DITCH INSTALLATIONS AT DRAINAGE STRUCTURES**


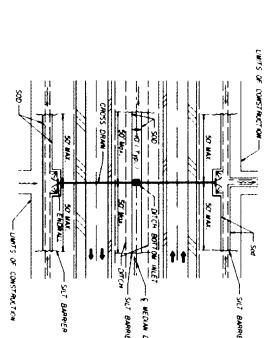


**RECOMMENDED SPACING FOR BALED HAY BARRIERS AND TYPE III SILT FENCE**



**VOLUNTEER TOWN**

### PROTECTION AROUND INLETS OR SIMILAR STRUCTURES

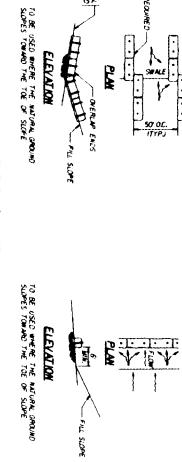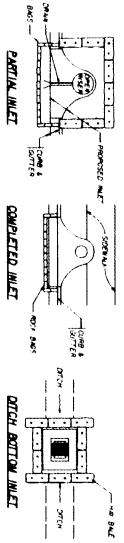

**AT TOP OF SLOPE**

**ELEVATION**

**PLAN**

**AT SIDE OF SLOPE**

**ELEVATION**


**PLAN**

**ON GROUNDSIDE**



**ELEVATION**

**PLAN**



### BARRIERS FOR FULL SLOPES

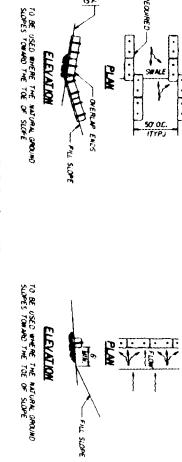



### PARTIAL INLET

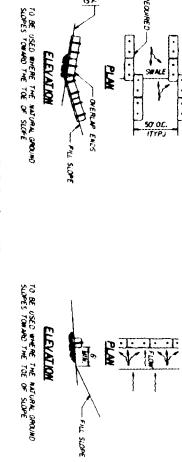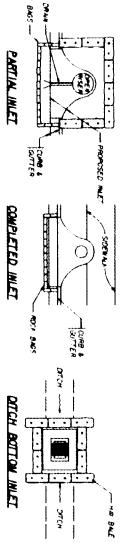



### COMPLETED INLET

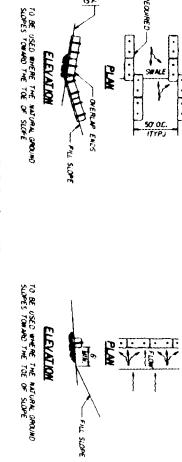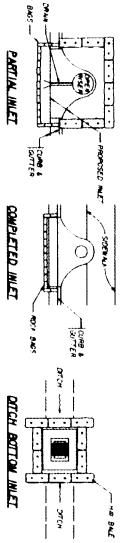



### DITCH BOTTOM INLET

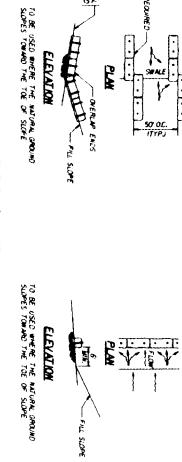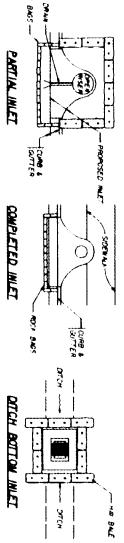



### PROTECTION AROUND INLETS OR SIMILAR STRUCTURES

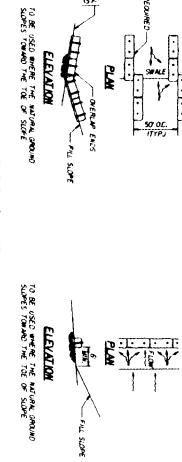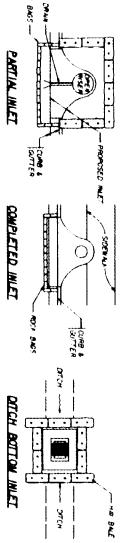



### ELEVATION

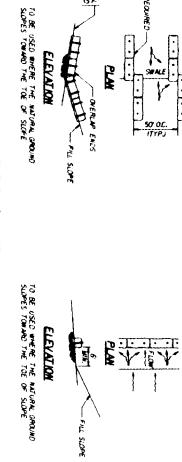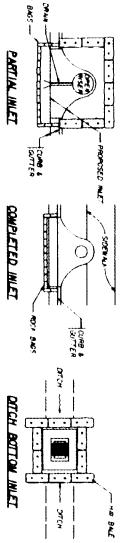


### PLAN

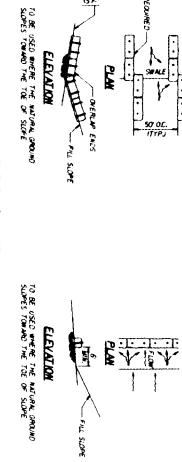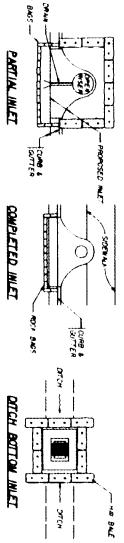



### ELEVATION

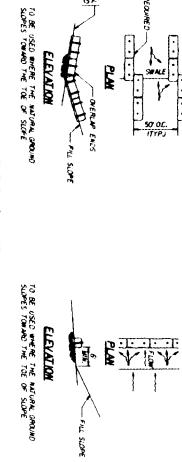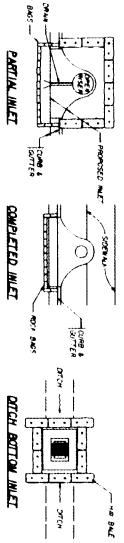


### PLAN

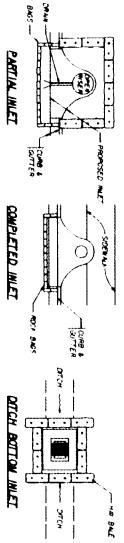



### ELEVATION

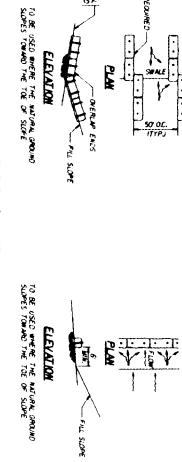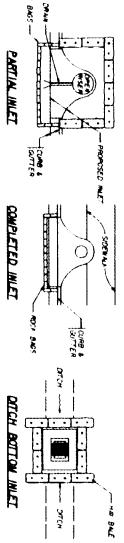


### PLAN

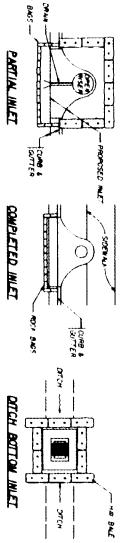



### ELEVATION

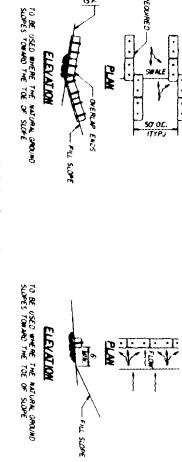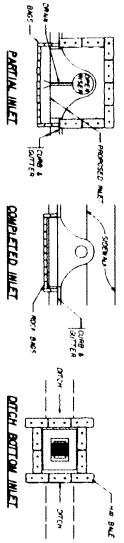


### PLAN

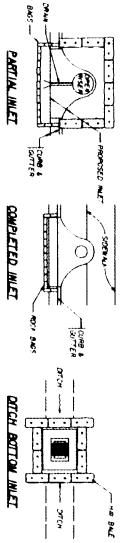



### ELEVATION

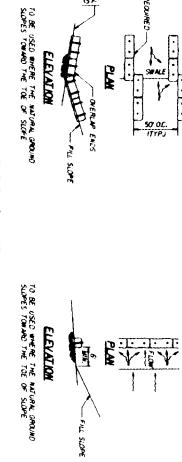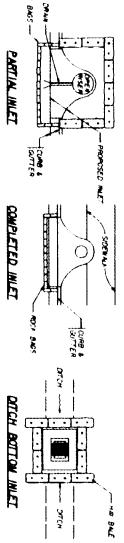


### PLAN

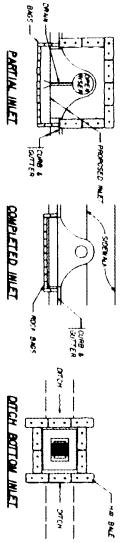



### ELEVATION

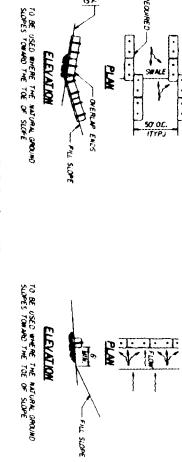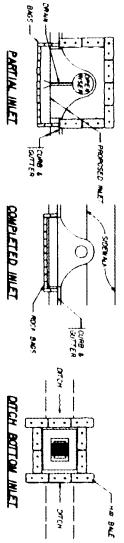


### PLAN

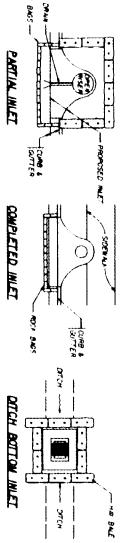



### ELEVATION

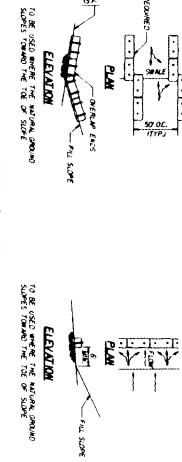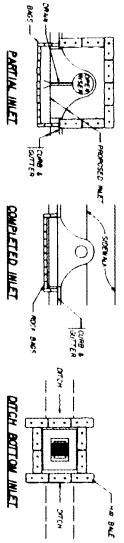


### PLAN

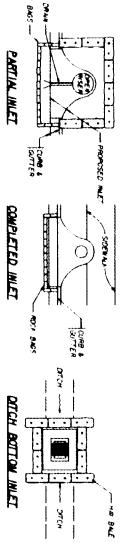



### ELEVATION

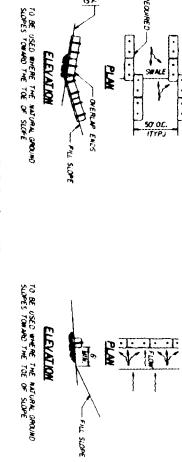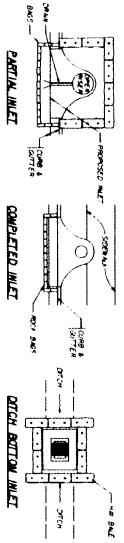


### PLAN

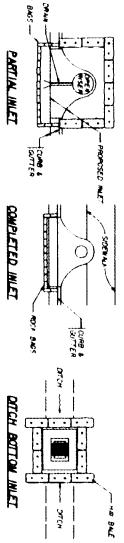



### ELEVATION

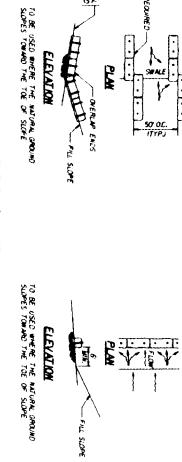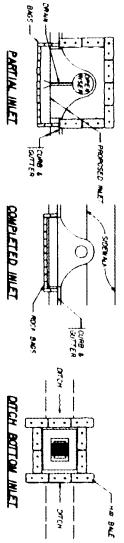


### PLAN

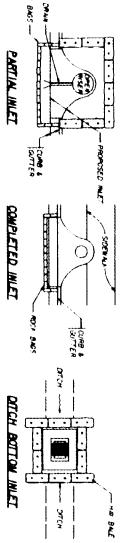



### ELEVATION

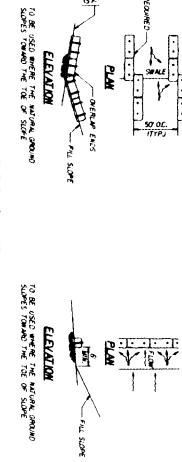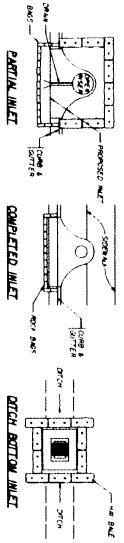


### PLAN

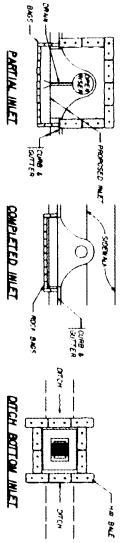



### ELEVATION

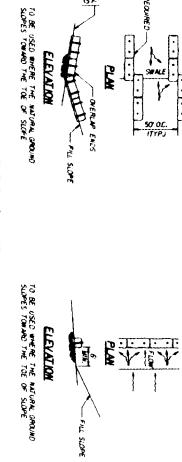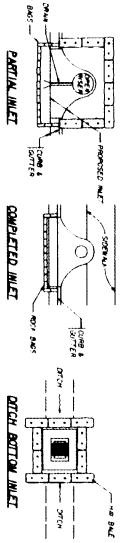


### PLAN

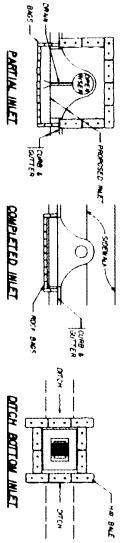



### ELEVATION

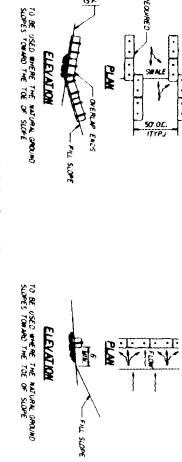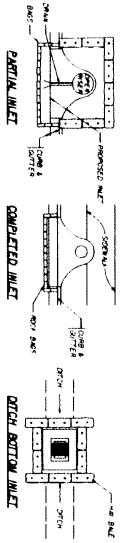


### PLAN

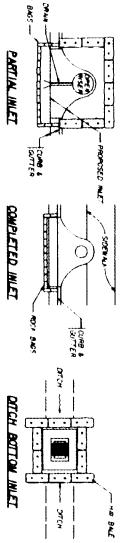



### ELEVATION

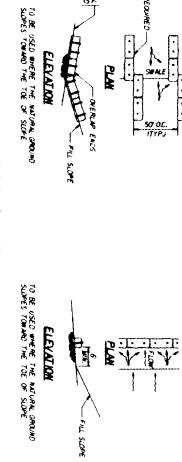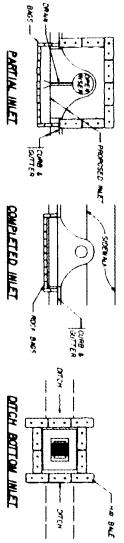


### PLAN

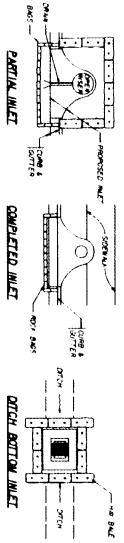



### ELEVATION

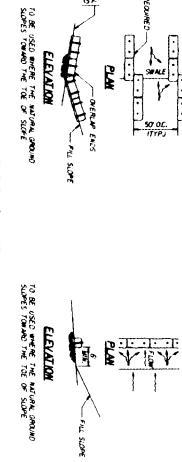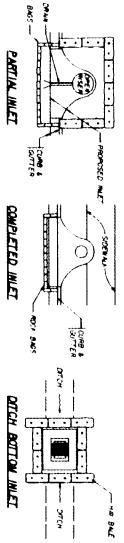


### PLAN

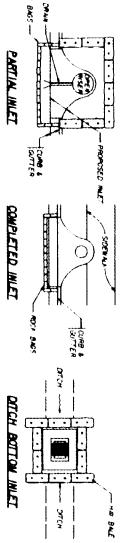



### ELEVATION

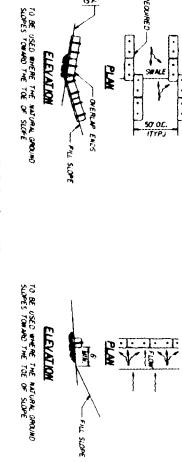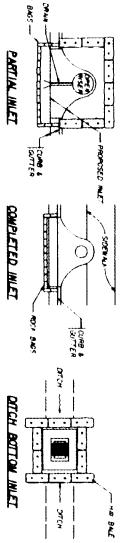


### PLAN

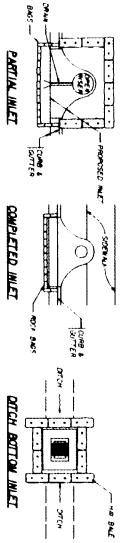



### ELEVATION

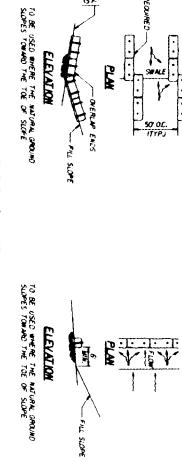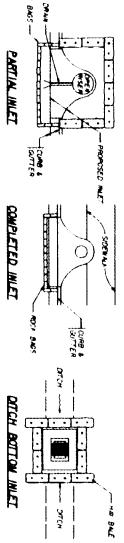


### PLAN

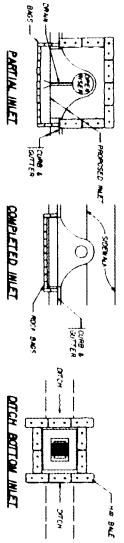



### ELEVATION

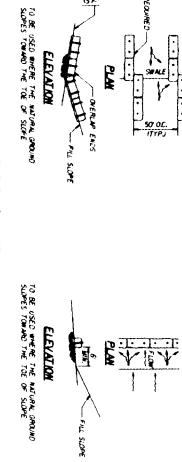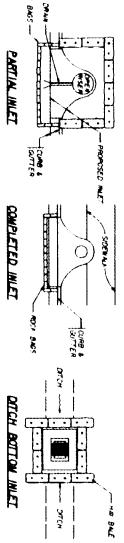


### PLAN

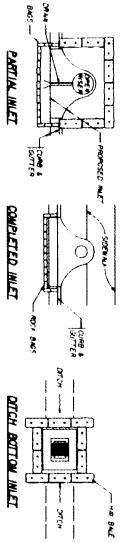



### ELEVATION

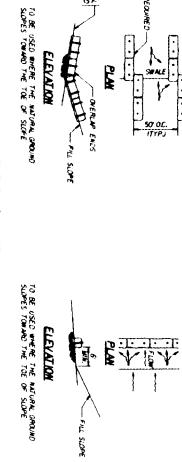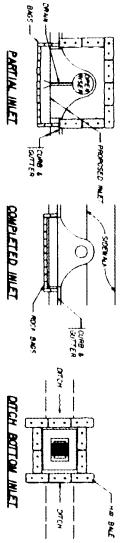


### PLAN

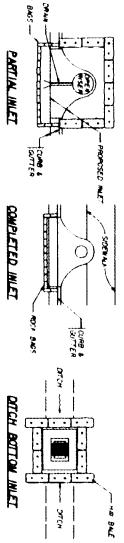



### ELEVATION

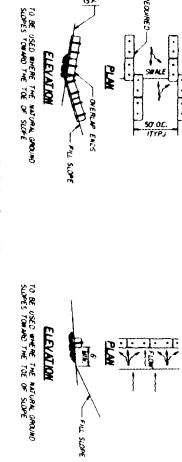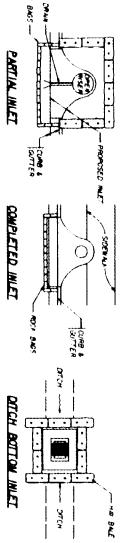


### PLAN

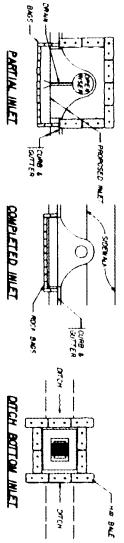



### ELEVATION

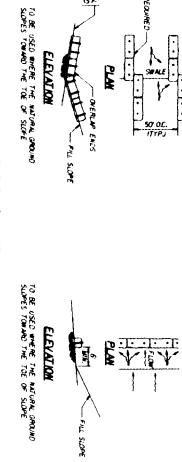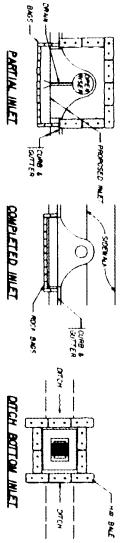


### PLAN

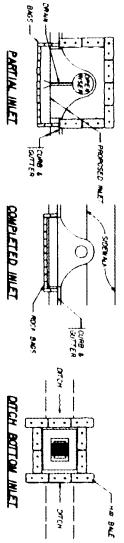



### ELEVATION

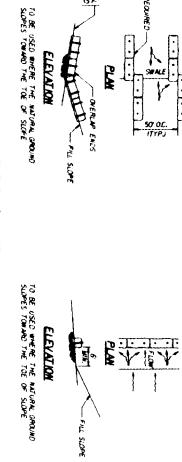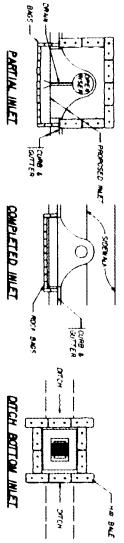


### PLAN

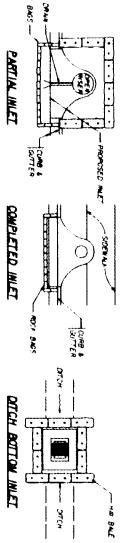



### ELEVATION

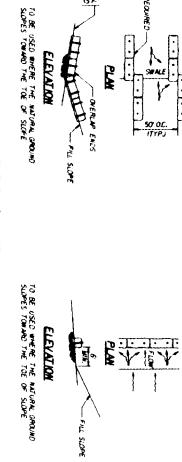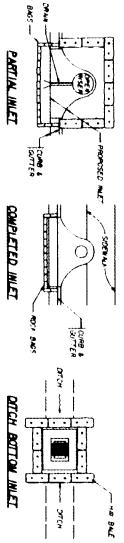


### PLAN

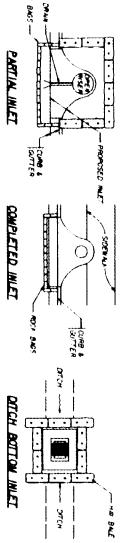



### ELEVATION

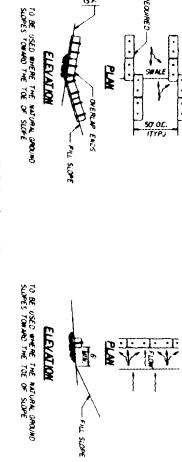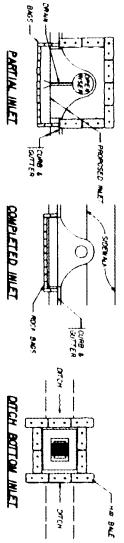


### PLAN

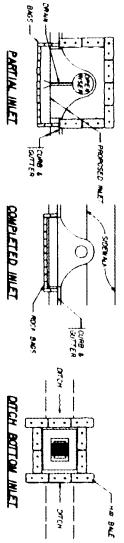



### ELEVATION

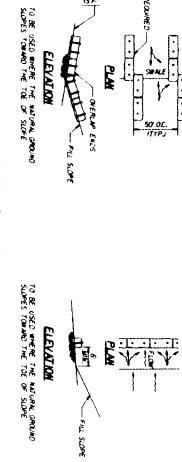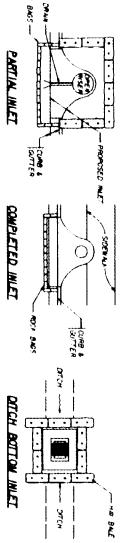


### PLAN

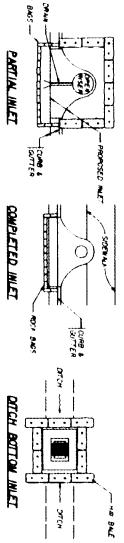



### ELEVATION

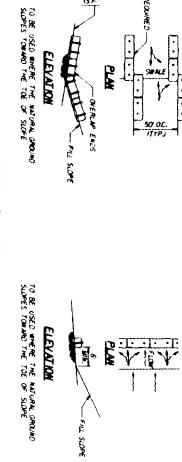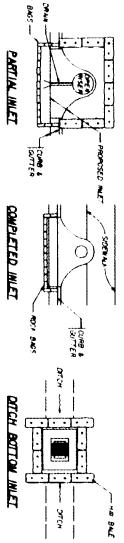


### PLAN

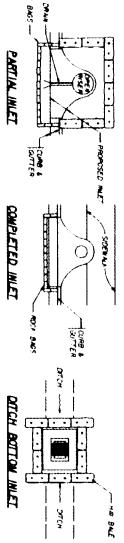



### ELEVATION

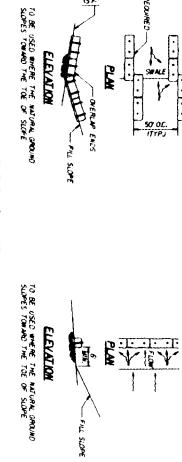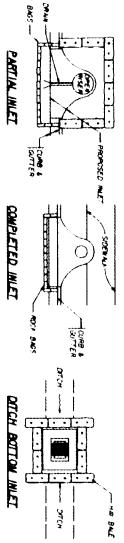


### PLAN

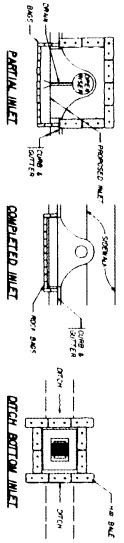



### ELEVATION

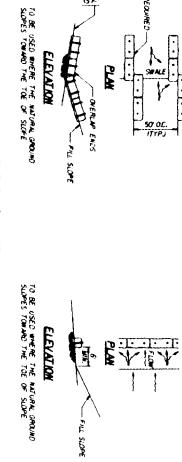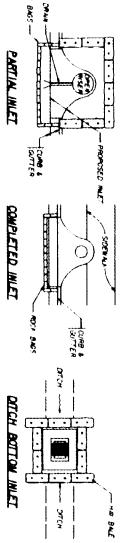


### PLAN

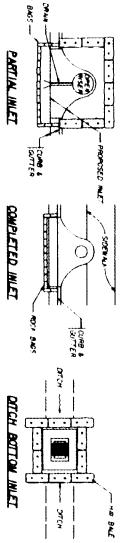


### ELEVATION

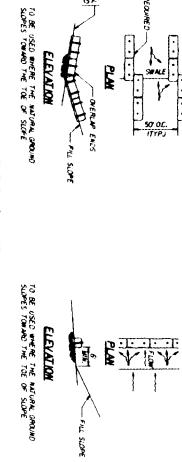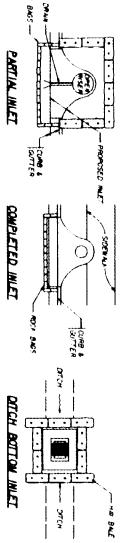



### PLAN

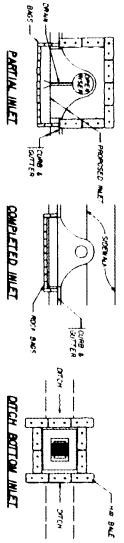

### ELEVATION

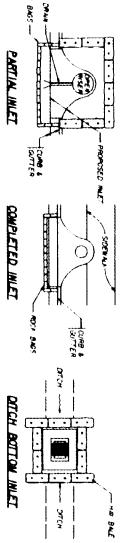

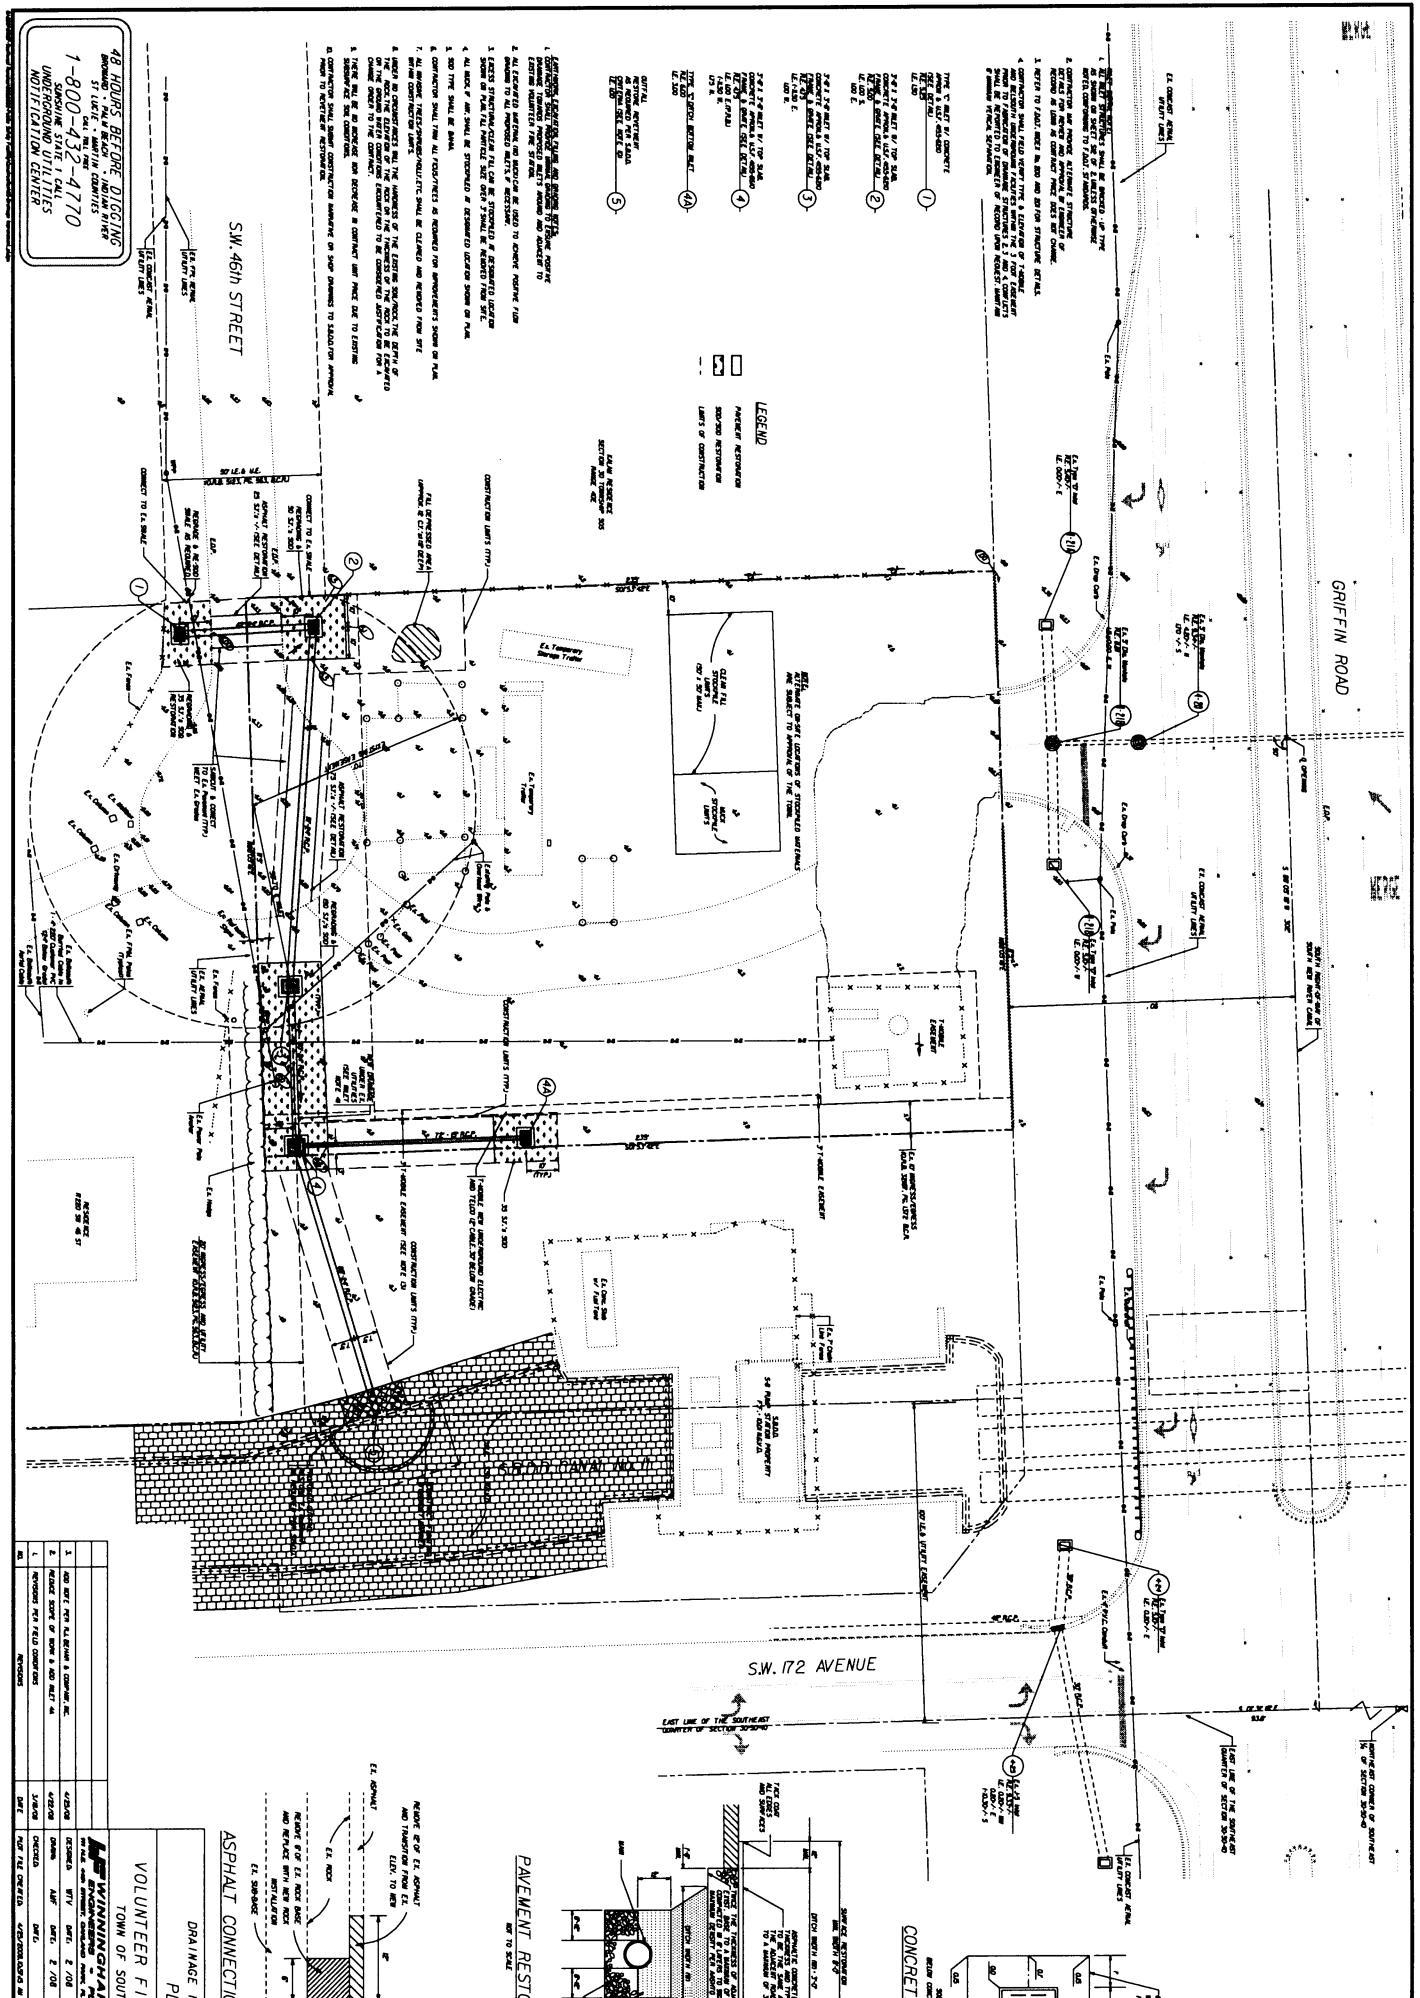

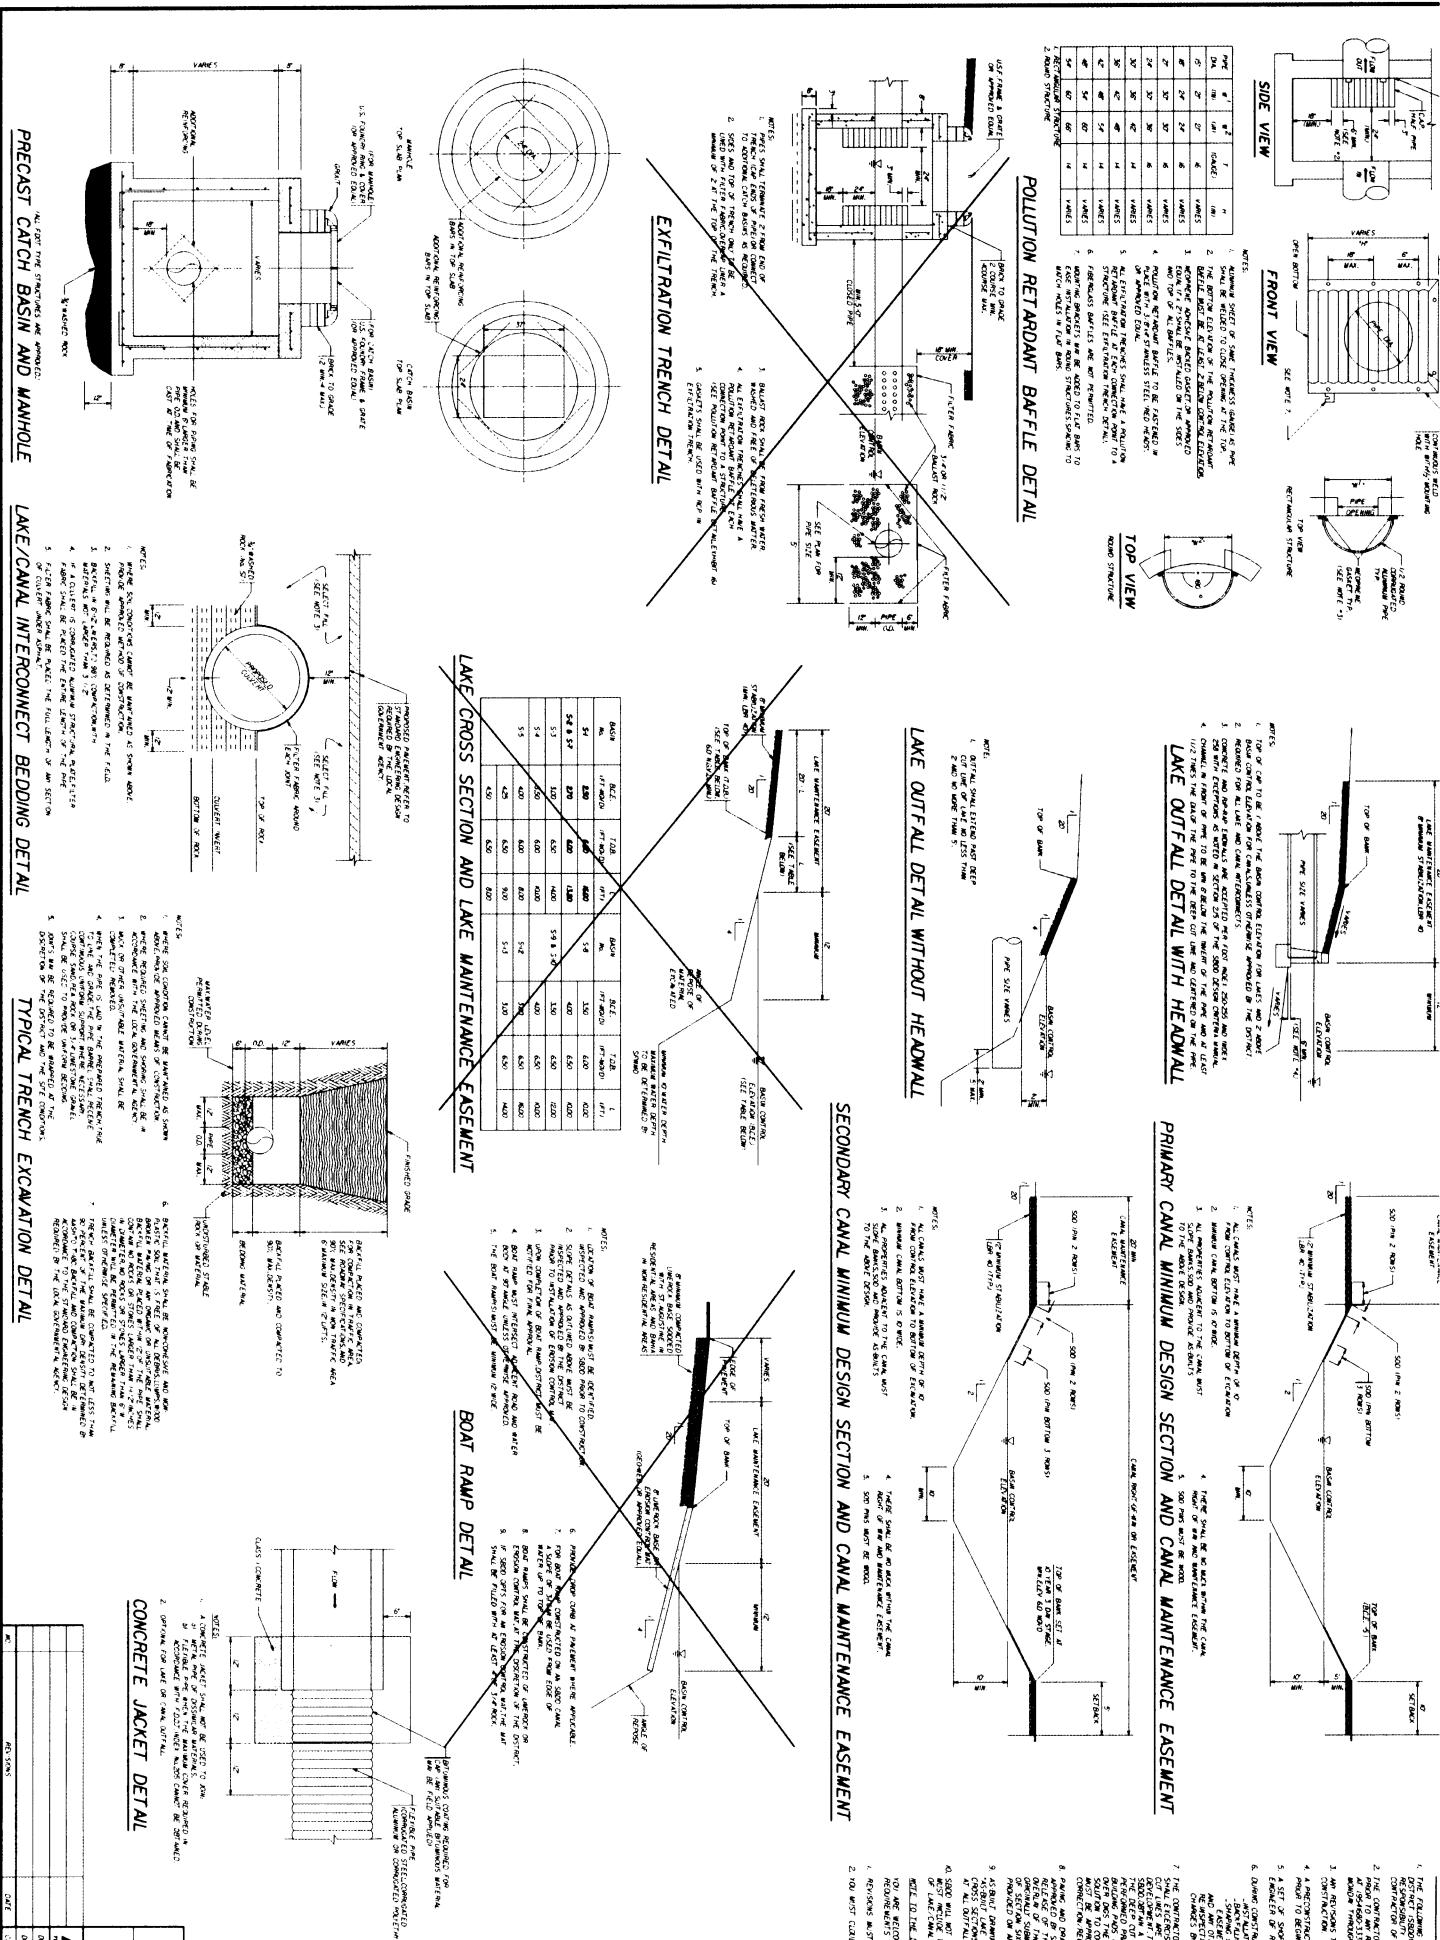

## PRECAST CATCH BASIN AND MANHOLE

### LAKE/CANAL INTERCONNECT BEDDING DETAIL

1

## TYPICAL TRENCH EXCAVATION DETAIL

10

CONCILE JACKSONIANUM

σ

1

卷之三

vi

"AMOR" BE MANTAINED AS SNE  
WDO OF CONSTRUCTION.

ACCESSION

20

ENVIRONMENTAL AGENCY.

NO ROCKS OR STONES LARGER

四百三

ויליאם

三

۷۸

1



# WEEKLEY ASPHALT PAVING, INC.

20701 Stirling Road • Pembroke Pines • Florida 33332  
BROWARD: (954) 680-8005 FAX: (954) 680-8671

WAP JOB NO.: 08052

CONTRACT NO.: H-Z-05-376-B1

COMMODITY CODE: 91395

PG NO.: 1

DESCRIPTION: SW 46th Street Volunteer Fire Department Drainage Improvements

Bid Item	Quantity	Unit	Unit Price	Description	Proposed Amount
6	6.00	HR	\$147.00	Survey As Built (Signed & Sealed)	\$ 882.00
25	40.00	EA	\$14.00	Baled Hay or Straw	\$ 560.00
26	60.00	LF	\$26.00	Floating Turbidity Barrier	\$ 1,560.00
28	250.00	LF	\$3.50	Staked Silt Fence (Type III)	\$ 875.00
29	0.32	Acre	\$9,000.00	Clearing and Grubbing	\$ 2,880.00
64	10.00	TN	\$195.00	Miscellaneous Asphalt Pavement	\$ 1,950.00
67	4.00	CY	\$990.00	Class I Concrete (Miscellaneous)	\$ 3,960.00
79	3.00	EA	\$3,100.00	Inlets (Ditch Bottom) (Type "C")	\$ 9,300.00
80	2.00	EA	\$3,850.00	Inlets (Ditch Bottom) (Type "D")	\$ 7,700.00
92	72.00	LF	\$61.00	Concrete Pipe Culvert (15") (Class III)	\$ 4,392.00
95	295.00	LF	\$79.50	Concrete Pipe Culvert (24") (Class III)	\$ 23,452.50
156	270.00	SY	\$4.45	Sod (Argentine Bahia)	\$ 1,201.50
				Additional Laborer (Inc all Pay/Fringe Benefits) - Soft Dig to Locate Underground Utilities; Survey and Layout of Construction Areas	\$ 1,085.00
171	35.00	HR	\$31.00	Pass Thru - Remove and Restore Revetment per S.B.D.D. Criteria	\$ 10,340.00
	1.00	LS	\$10,340.00		
				<b>TOTAL</b>	<b>\$ 70,138.00</b>

This is only a "Budget Quote" based on what should be expected. The actual cost will be based on field measurements and as agreed to by the owner and Weekly Asphalt Paving, Inc.

\* Price does not include permit fees

\* Price Based Upon Plans Supplied by The Town of Southwest Ranches - Wintingham and Fradley, Inc.